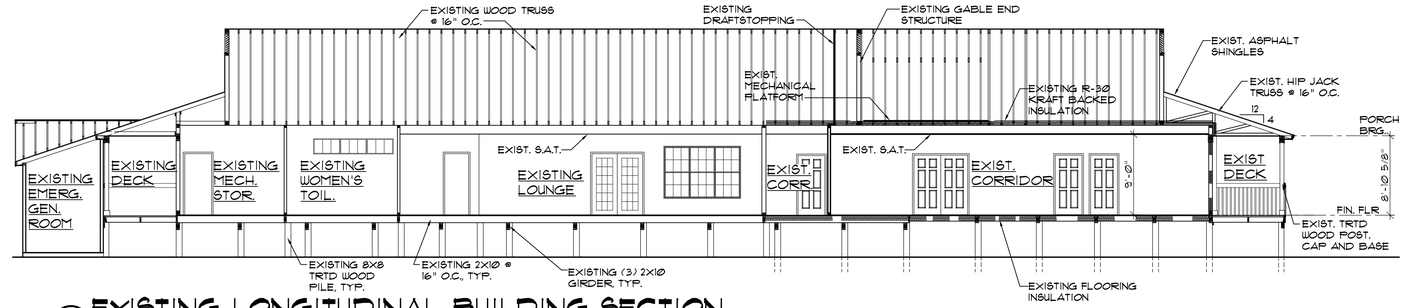

7 EX-1 EXISTING LONGITUDINAL BUILDING SECTION
SCALE: 1/8"=1'-0"

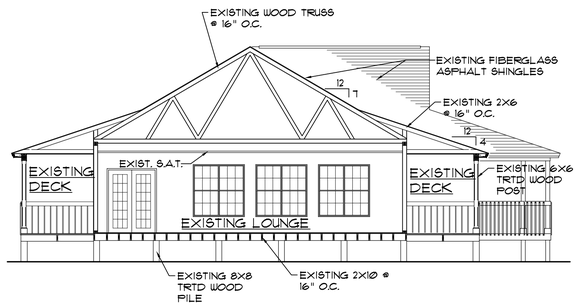

6 EX-1 EXISTING TRANVERSE BUILDING SECTION
SCALE: 1/8"=1'-0"

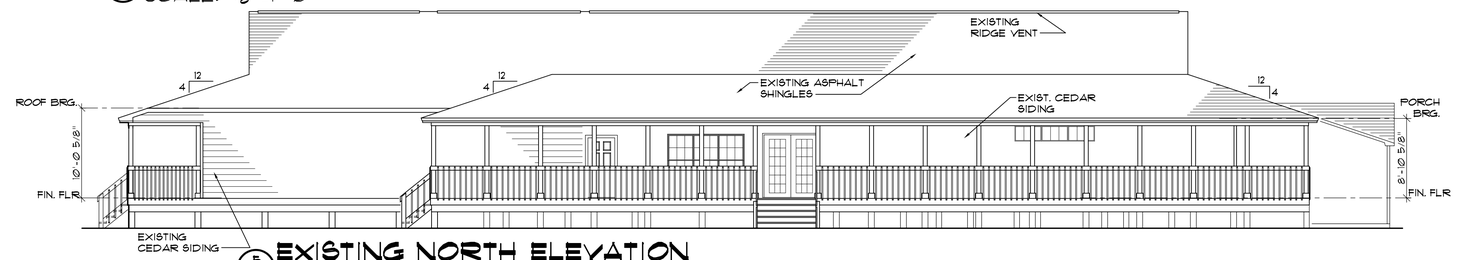

5 EX-1 EXISTING NORTH ELEVATION
SCALE: 1/8"=1'-0"

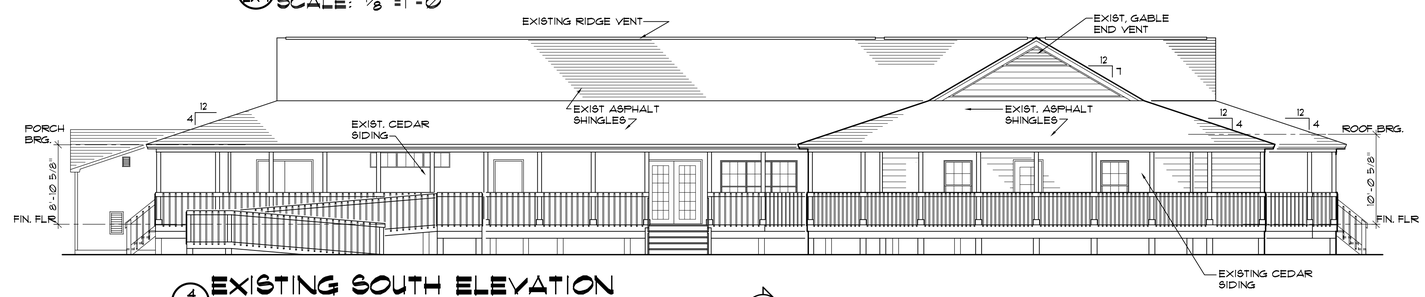

4 EX-1 EXISTING SOUTH ELEVATION
SCALE: 1/8"=1'-0"

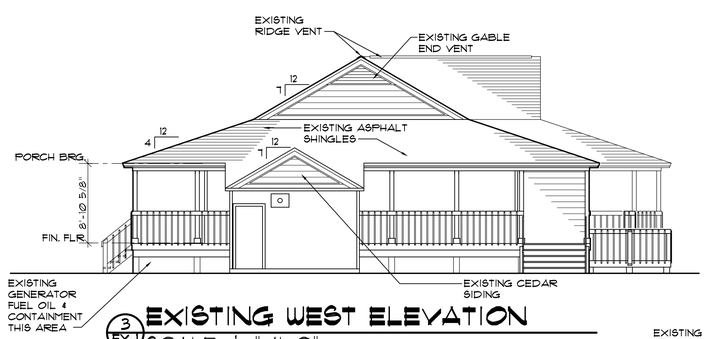

3 EX-1 EXISTING WEST ELEVATION
SCALE: 1/8"=1'-0"

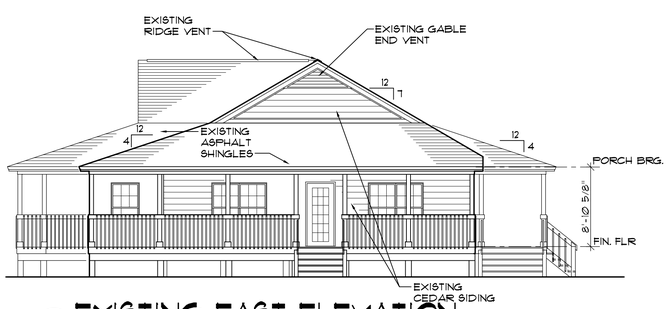

2 EX-1 EXISTING EAST ELEVATION
SCALE: 1/8"=1'-0"

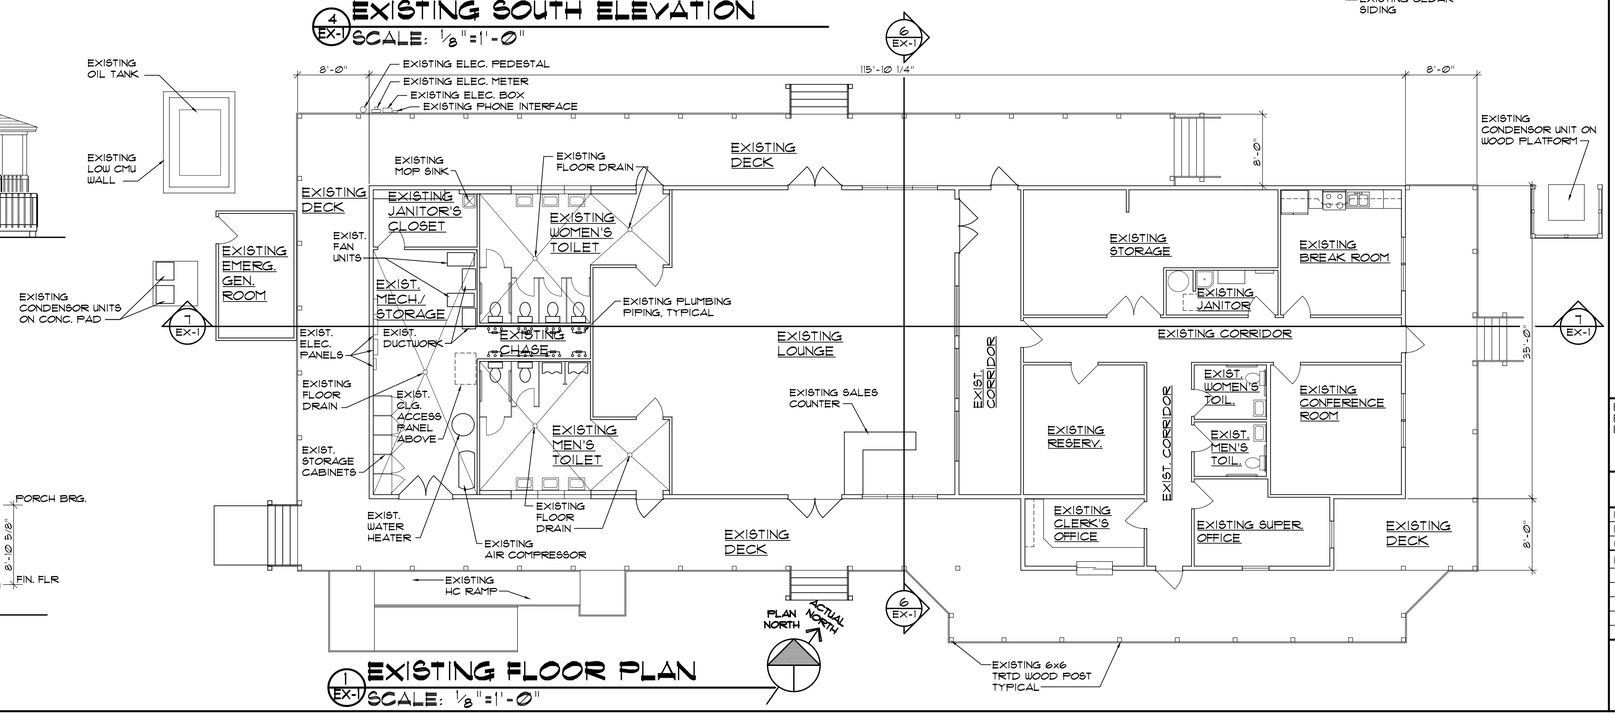

1 EX-1 EXISTING FLOOR PLAN
SCALE: 1/8"=1'-0"

RECORD DRAWING
FIELD VERIFY ALL CONDITIONS

USE OF THIS DRAWING, SPECIFICATIONS, AND OTHER DOCUMENTS:
These drawings, specifications, and other documents, including, but not limited to, drawings, specifications, and other documents, are instruments of service for use solely with respect to this project. The Owner shall be permitted to reproduce and distribute copies for information and reference in connection with the project. No portions of the drawings or other documents may be reproduced or used without written consent by the designer.

4206 Bridges Street Extension, Suite C
Morehead City, North Carolina 28557
Telephone: 252-247-7171 Fax: 252-247-4004
Email: eda@EDApa.com
Raleigh
Morehead City
EDA pa
Architects □ Engineers □ Planners

CEDAR ISLAND FERRY OFFICE RENOVATION
CEDAR ISLAND, NORTH CAROLINA

EXISTING FLOOR PLAN, ELEVATIONS AND BUILDING SECTIONS

2007412

ISSUED:	30 DEC 08
DWG BY:	MLR
CKD BY:	RMB,LDD
REVISIONS	

SHEET NO.
EX-1
OF